BRUHAT BANGALORE MAHANAGARA PALIKE

Developments works to be under taken in Ward No.05 of BBMP around Solid Waste Disposal Processing units Bellahalli, D Bagaluru and Kattigenahalli Byatarayanapura Constituency

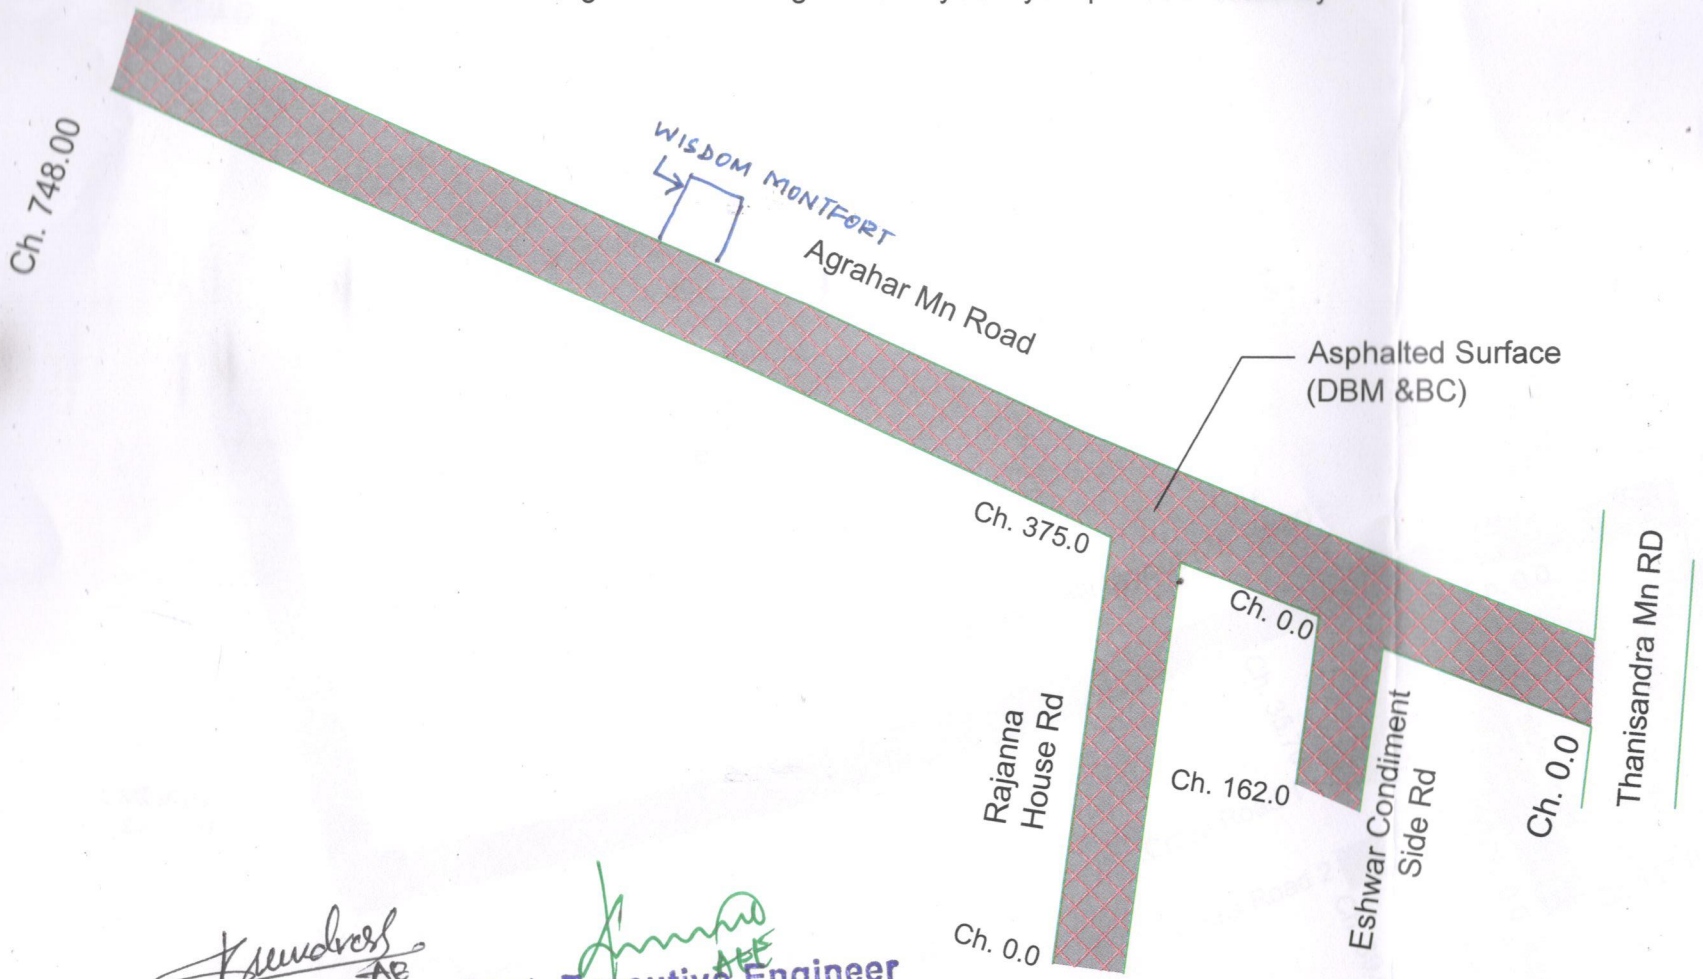

AE

Asst. Executive Engineer
Project Division
Yelahanka Zone
BBMP, Bangalore - 92

NOTE:-

1. ALL DIMENSION & LEVELS ARE Mts. UNLESS OTHERWISE MENTIONED.

DATE	No. OF PRINTS	PRINTS ISSUED TO	SIGN

DATE	REVISION	DESCRIPTIONS	SIGN

LEGEND:-

DBM

BC

CONSULTANT :

TEJUS CONSULTANTS

No.58 MIG, 6th Cross, 3rd Main
1st Stage, Basaveshwaranagar
Bangalore-560079
TEL: 080 - 23287532
email: tejusconsultants@gmail.com

TITLE: As Built Drawing 1/1

BRUHAT BANGALORE MAHANAGARA PALIKE

Developments works to be under taken in Ward No.05 of BBMP around Solid Waste Disposal Processing units Bellahalli, D Bagaluru and Kattigenahalli Byatarayanapura Constituency

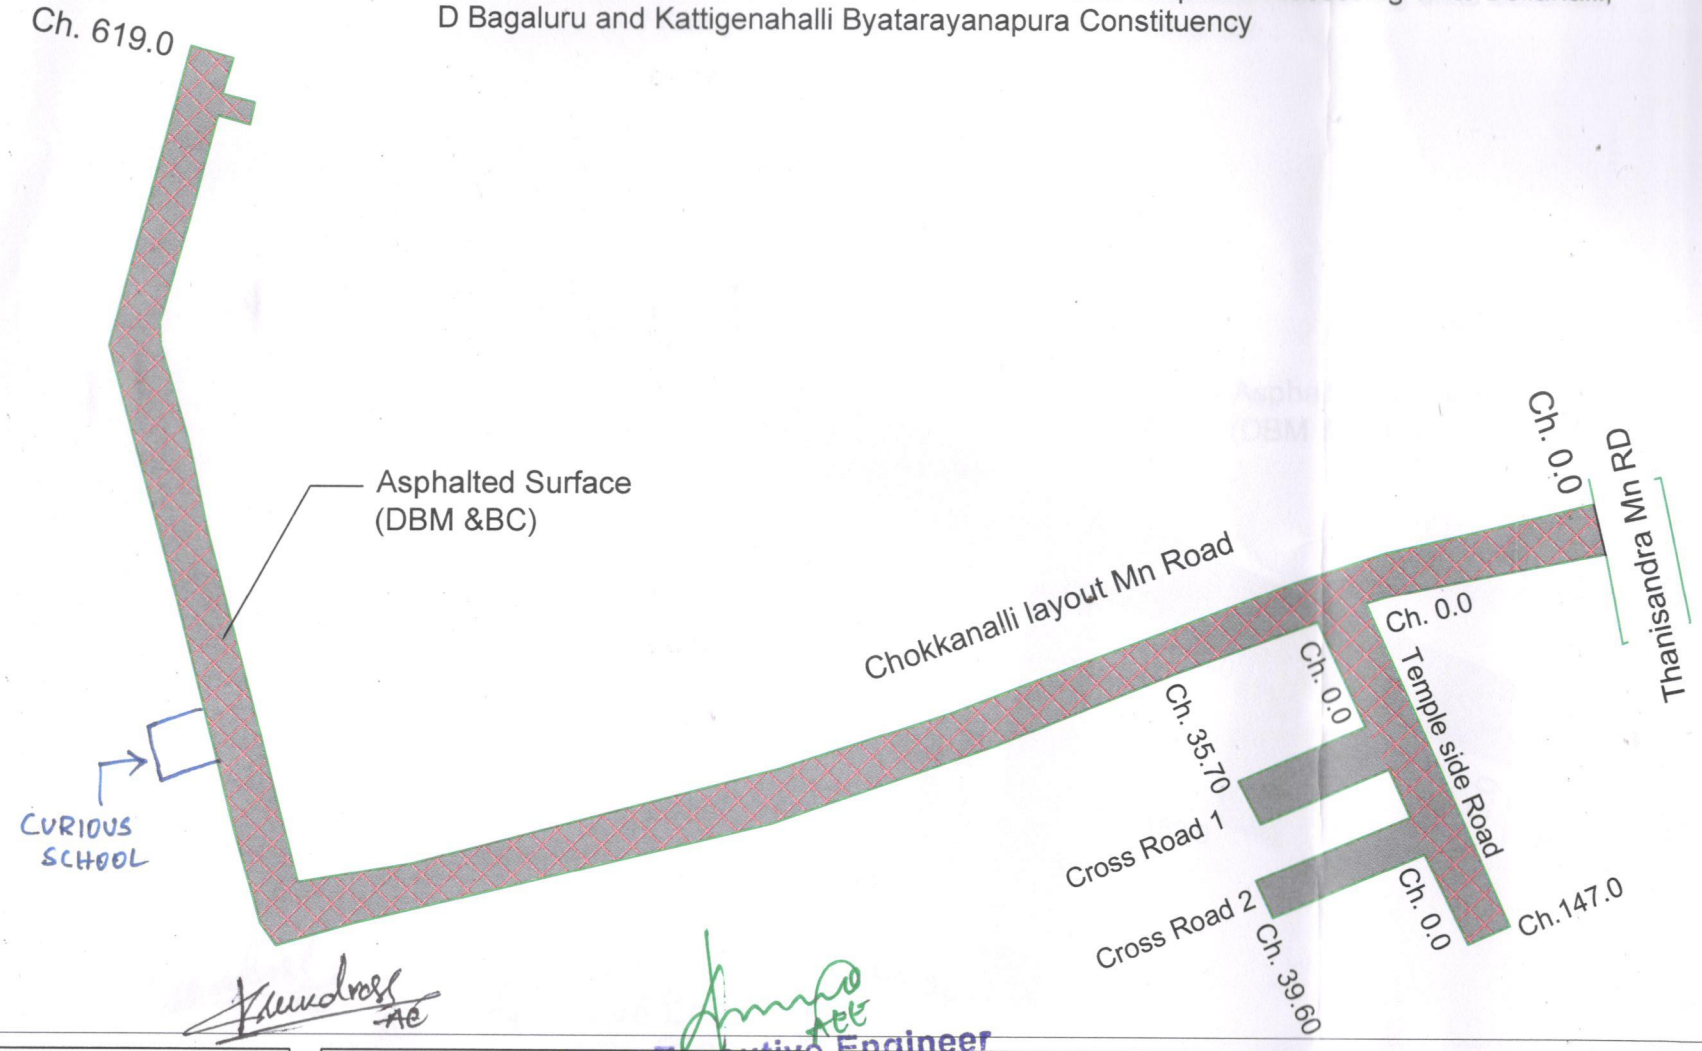

Asst. Executive Engineer
Project Division
Yelahanka Zone
BBMP, Bangalore - 92

NOTE:-

1. ALL DIMENSION & LEVELS ARE Mts. UNLESS OTHERWISE MENTIONED.

DATE	No. OF PRINTS	PRINTS ISSUED TO	SIGN

DATE	REVISION	DESCRIPTIONS	SIGN

LEGEND:-

DBM

BC

CONSULTANT :

TEJUS CONSULTANTS

No.58 MIG, 6th Cross, 3rd Main
1st Stage, Basaveshwaranagar
Bangalore-560079
TEL: 080 - 23287532
email: tejusconsultants@gmail.com

TITLE:

As Built Drawing

1/1